

# SITE PLAN

MILLESVILLE TOWNSHIP, LAKE COUNTY, OHIO

for: BUETT & BACK 743-1200 57905

ADDRESS	STREET	CITY	ZIP
HERBERT STALE 544			
REVISION 2-35	NAME	VOLUME	PAGE
129	NO. GARWOOD DR.	129	1
SUBLOT NO.	STREET	PERM. PARCEL NO.	STREET

LEGEND	
SANITARY MANHOLE	WATER VALVE (GAS)
STORM MANHOLE	WATER METER (GAS)
INLET OR CATCH BASIN	AS BUILT ELEVATION
HYDRANT	INDICATES DIRECTION OF SURFACE DRAINAGE
EXISTING CONTOURS	
PROPOSED CONTOURS	
EXIST. ELEV.	PROF. ELEV.

## REMARKS

ALL BOUNDARY DATA SHOWN WAS OBTAINED FROM IDEEDS, RECORDED SUBDIVISION PLAT OR OTHER PUBLIC RECORDS. LOCATIONS AS SHOWN OF ADJACENT WELLS AND SEPTIC TANKS OBTAINED FROM LAKE COUNTY HEALTH DEPARTMENT.

## DESIGN CERTIFICATION

THIS PLAN WAS PREPARED BY ME, AND IS CORRECT TO THE BEST OF MY KNOWLEDGE AND BELIEF.

NAME: HARRY S. JONES, JR. SURVEYOR REGISTRATION NO. 5-6343

## CHECK LIST

NO. OF BEDROOMS		WATER MAIN SIZE LOCATION	
NO.	DATE	NO.	DATE
1	10-23-92	1	10-23-92
2		2	
3		3	
4		4	
5		5	

## PLAN PREPARED BY:

BABCOCK & JONES & ASSOCIATES, INC.

PAINESVILLE, OHIO


NO.	DATE	BY	SCALE	1" = 20'	PHONE NO.	357-1811
1	10-23-92	BT	DATE	3/5/92	DRAWING NO.	80-004-129
2		CHK'D	DATE	4/3	APPROV.	
3		CHIEF				

## "AS BUILT" CERTIFICATION

I, HEREBY CERTIFY THAT THE CIRCLED GRADES ARE EXISTING FINISH GRADES CHECKED IN THE FIELD ON 19 AND ARE CORRECT TO THE BEST OF MY KNOWLEDGE AND BELIEF.

REGISTERED SURVEYOR

REG. NO.

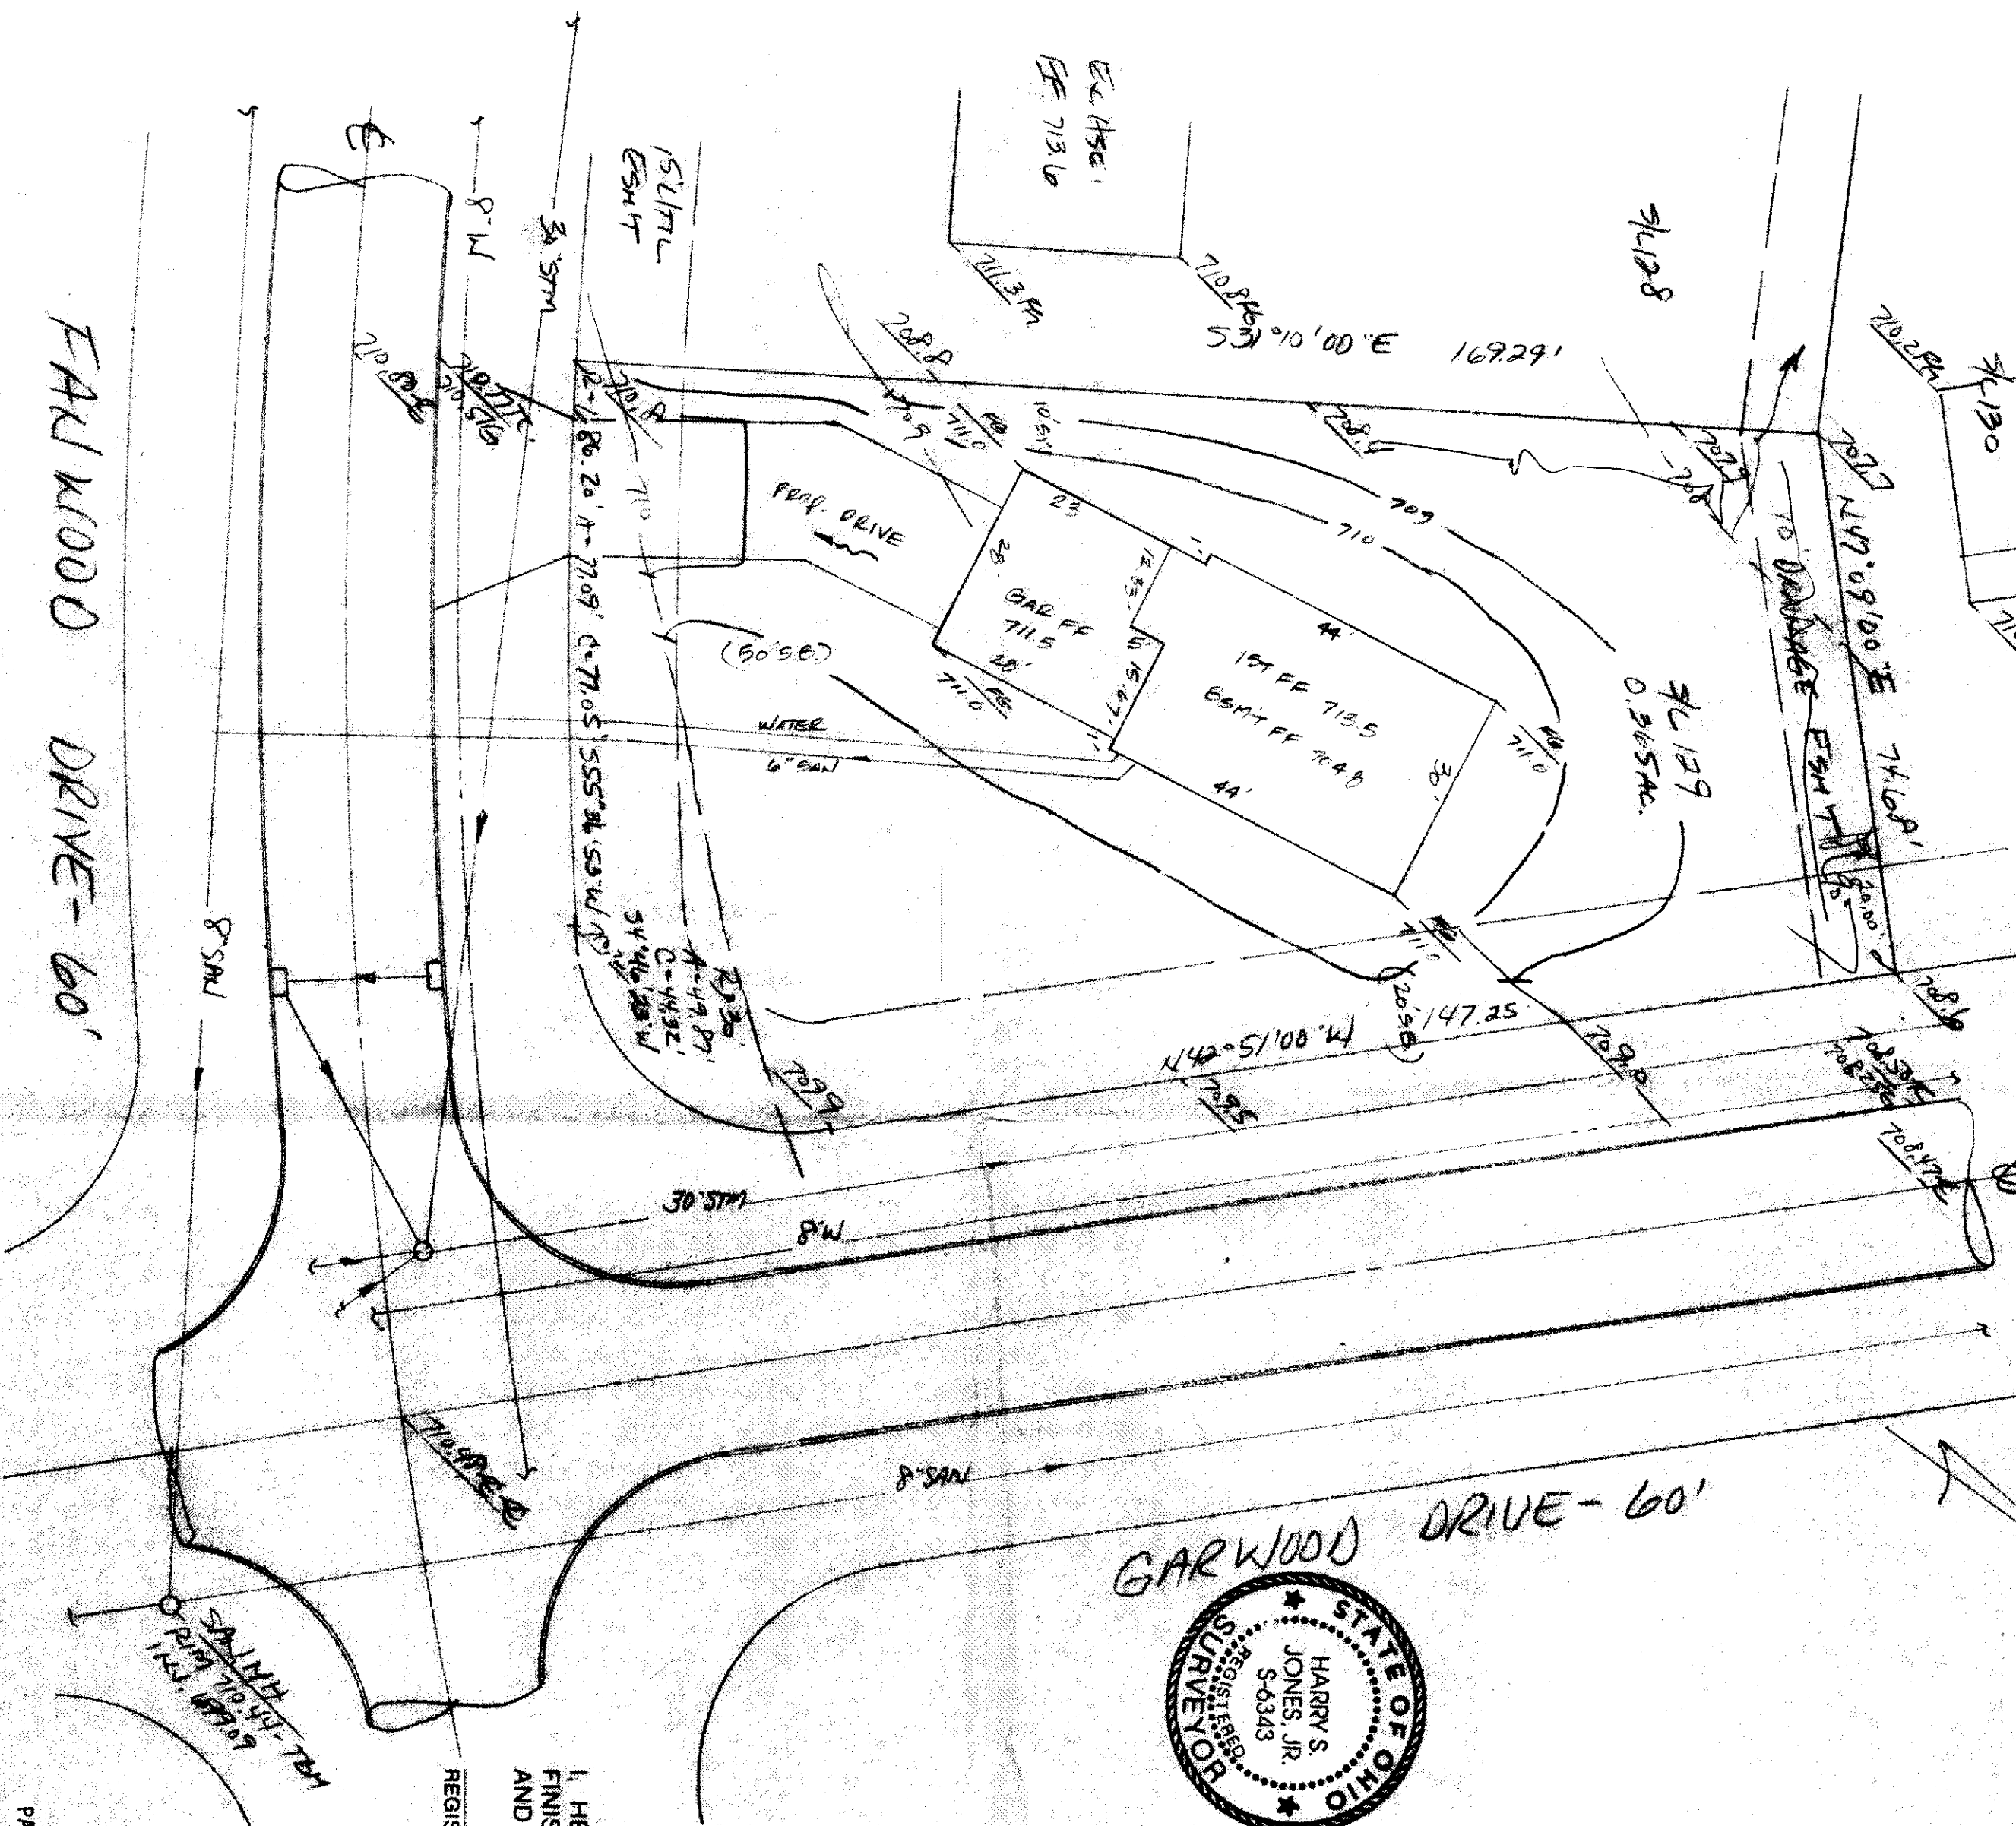

GARWOOD DRIVE - 60'

TBM - 1.14 54.4 M.H.  
ELEV. = 710.44

APPROVED  
PAINESVILLE TOWNSHIP  
ZONING DEPARTMENT  
#8310 100622  
By: G.H. Date: 10-29-92  
Swale as shown or provide A YARD BRAIN

Grading Plan Approved  
as shown and/or noted  
THOMAS P. GILLES, P.E.  
Lake County Engineer